


NOTE:
USE EXTREME CAUTION.
OVERHEAD POWER IN AREA.

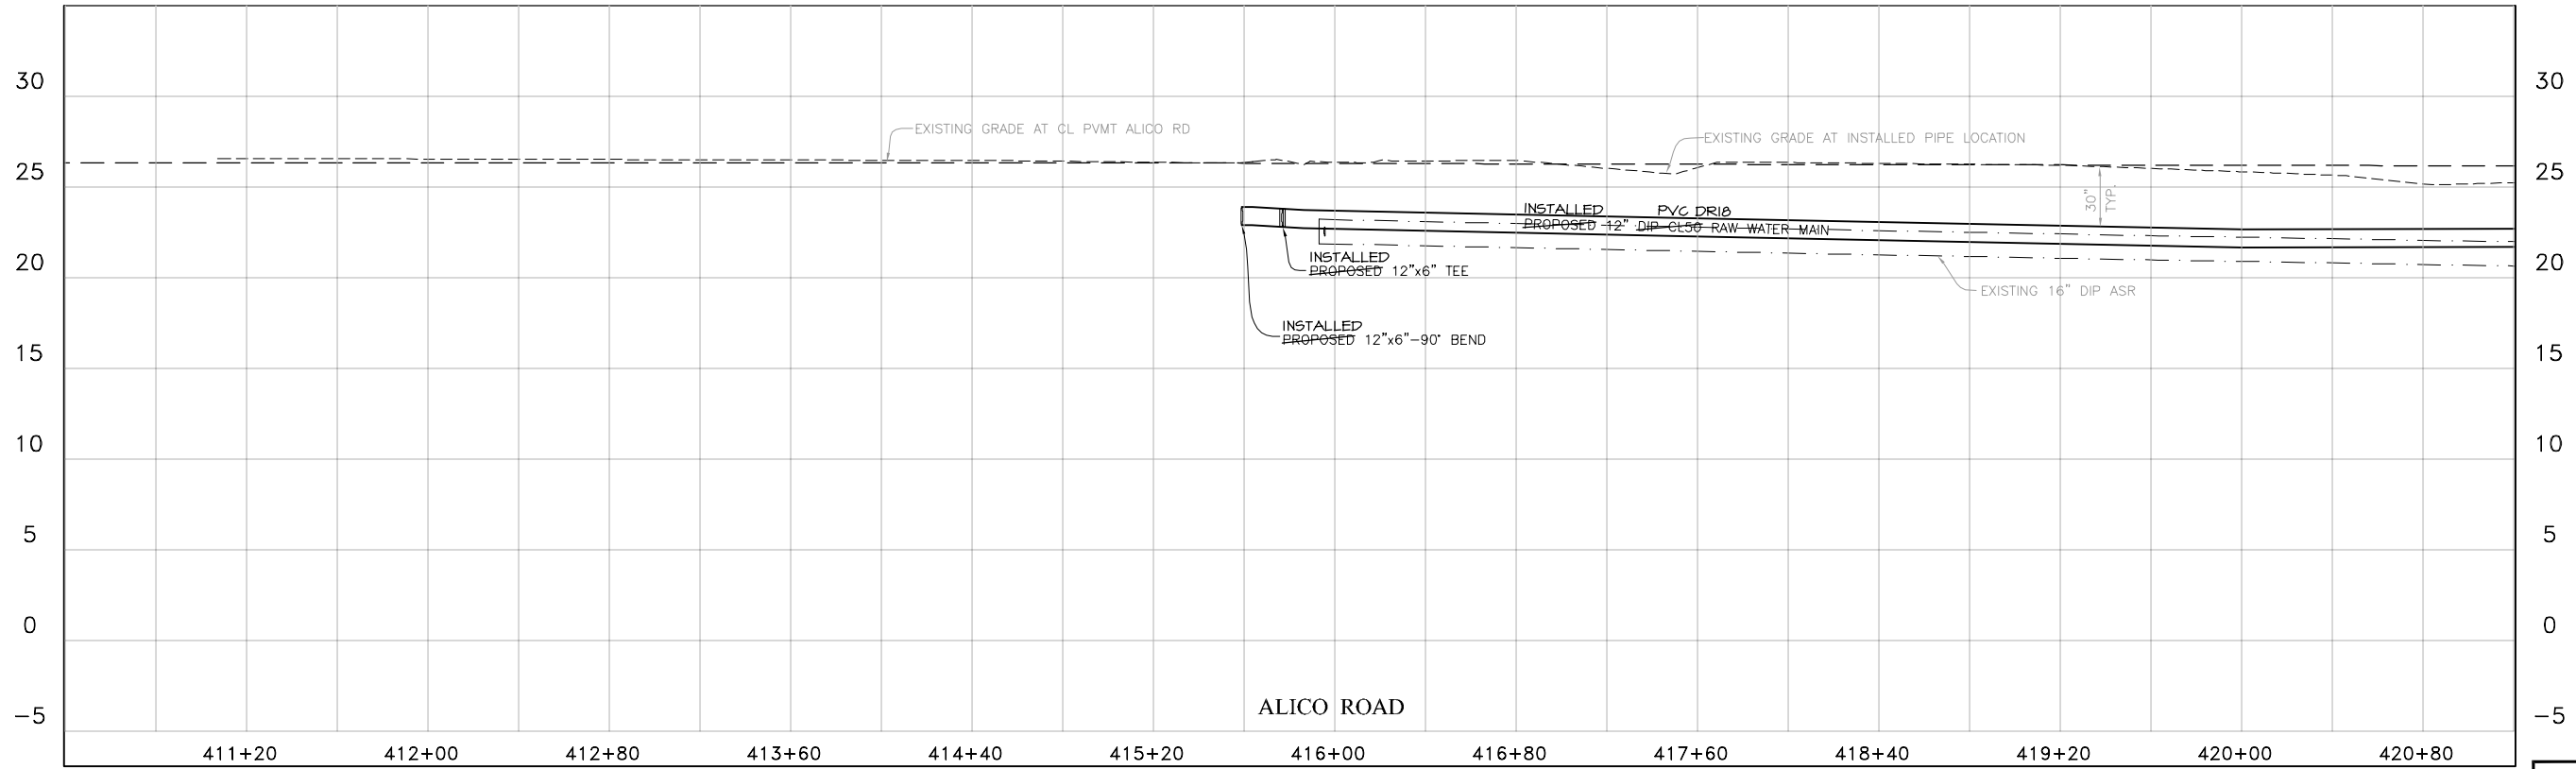

SCALE 1" = 40' HOR
1" = 5' VER

RECORD DRAWING

N:\20033735\WaterMgmt\RECORD DRAWINGS\PP-WTP_to Alico N.dwg (PP 1) ml2 Oct 01, 2009 - 11:40am

REVISIONS	



Corkscrew 5 MGD
Wellfield Expansion



ERIK LEE HOWARD, PE
FL License No. 66574

Plan and Profile - WTP to Alico North
Sta. 410+40 to Sta. 421+20

DATE	PROJECT NO.	FILE NO.	SCALE	SHEET
MARCH, 2006	20033735	16-46-26	As Shown	PP 1