


NOTE:  
USE EXTREME CAUTION.  
OVERHEAD POWER IN AREA.

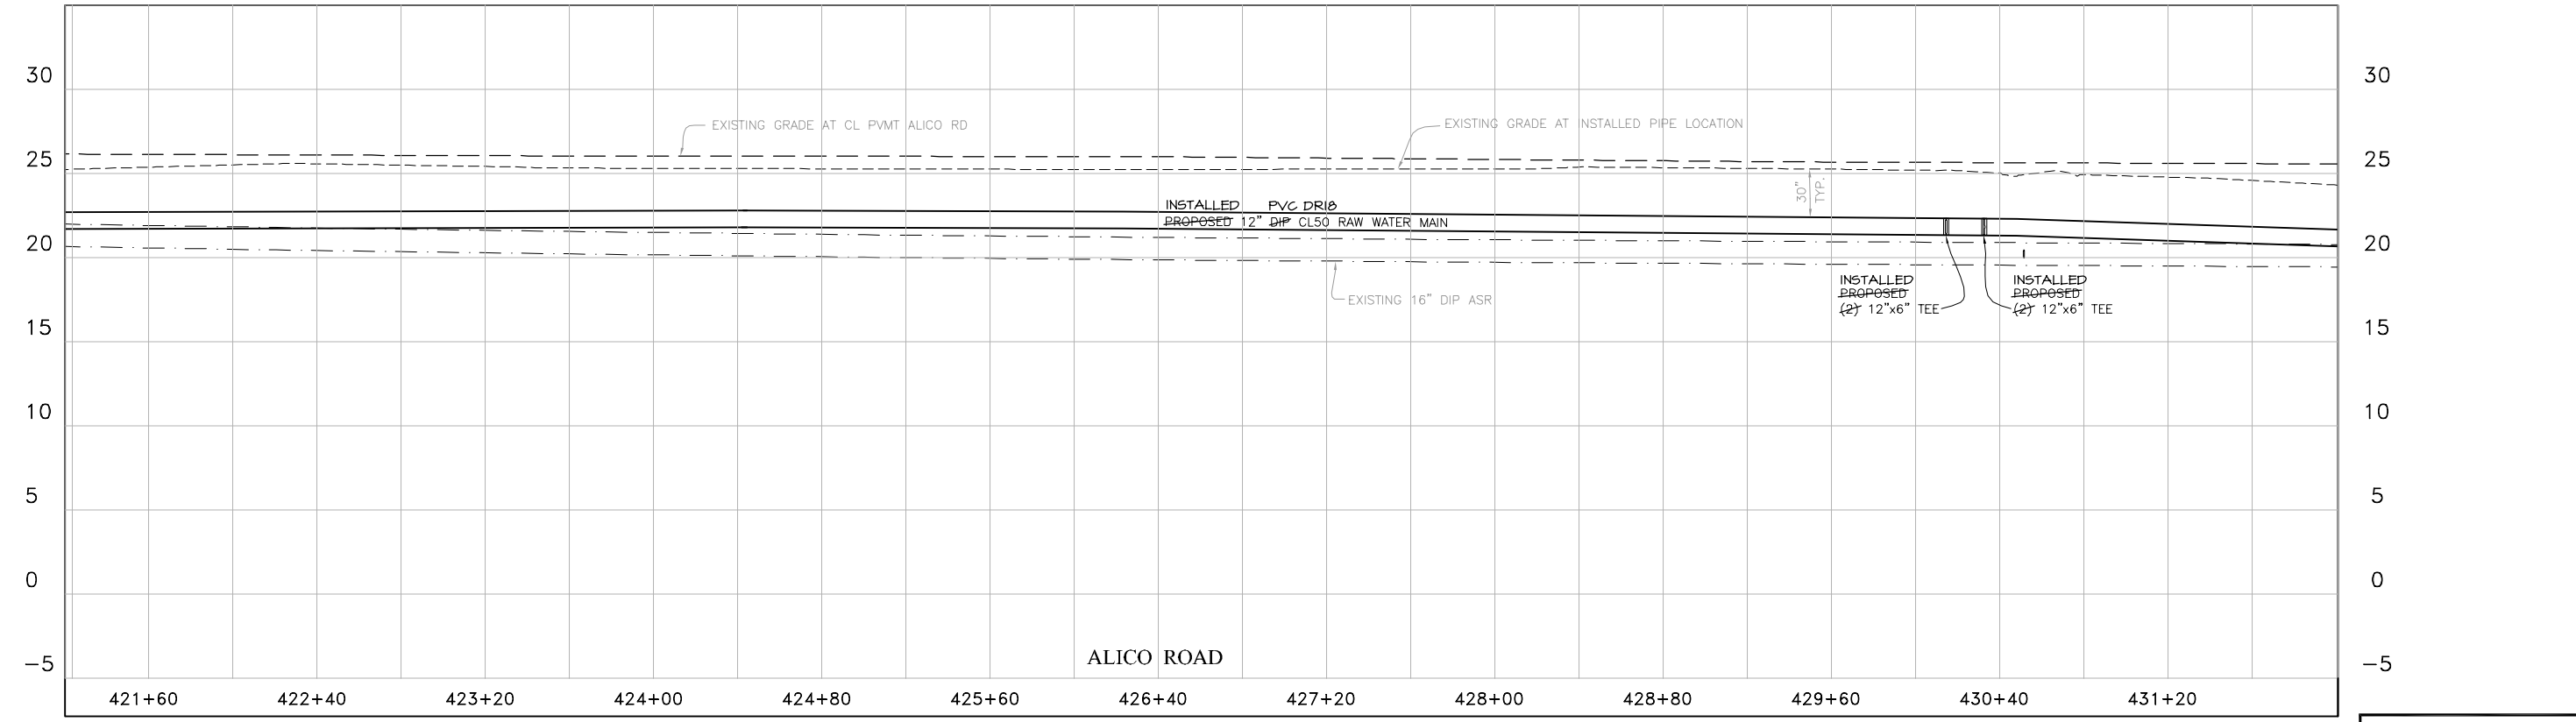

SCALE 1" = 40' HOR  
1" = 5' VER

**RECORD DRAWING**

N:\20033735\WaterMgmt\RECORD DRAWINGS\PP-WTP\_to Alico N.dwg (PP 2) ml2 Oct 01, 2009 - 11:37am

REVISIONS	



Corkscrew 5 MGD  
Wellfield Expansion



ERIK LEE HOWARD, PE  
FL License No. 66574

Plan and Profile - WTP to Alico North  
Sta. 421+20 to Sta. 432+00

DATE	PROJECT NO.	FILE NO.	SCALE	SHEET
MARCH, 2006	20033735	16-46-26	As Shown	PP 2