


PIG RETRIEVAL DETAIL
SCALE: 1" = 5'-0"

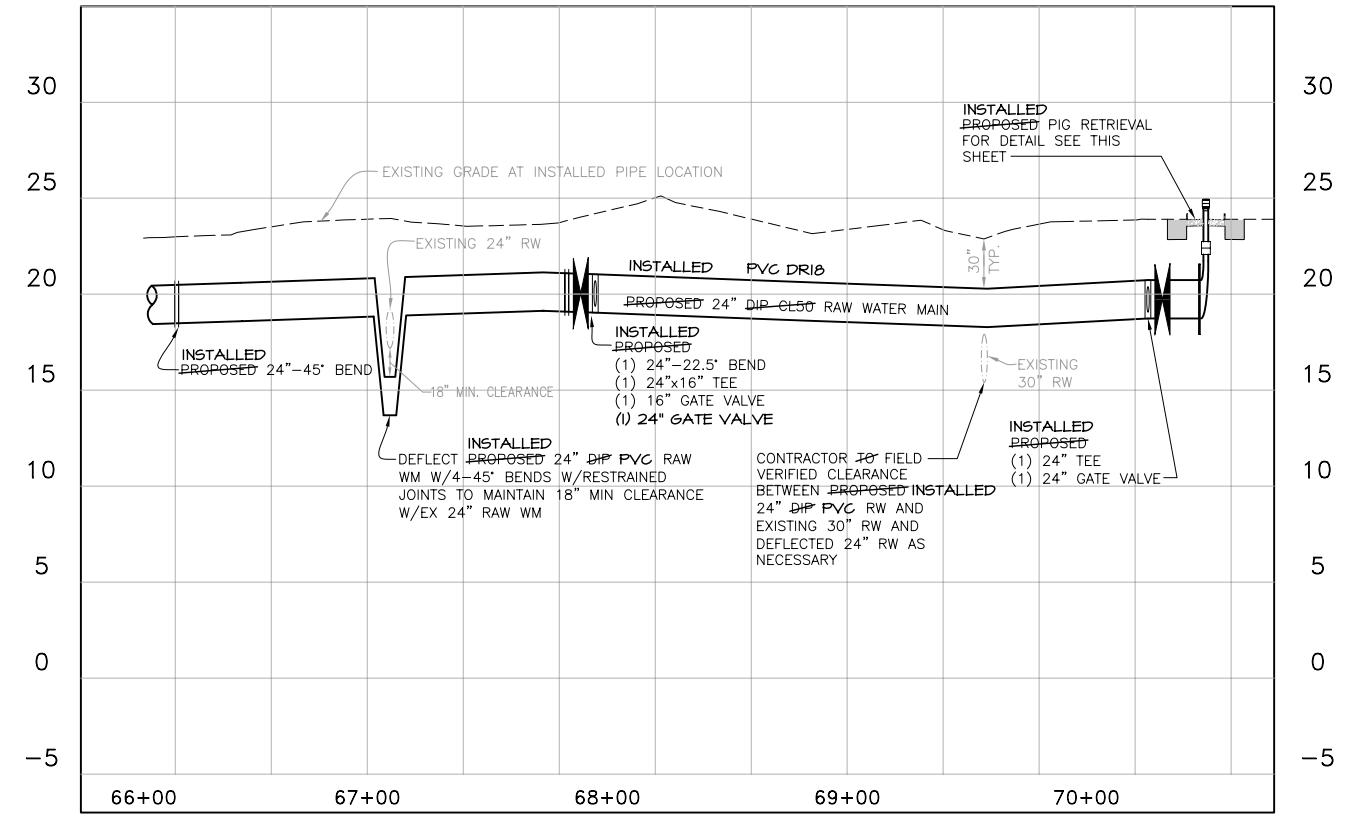

SCALE 1" = 40' HOR
1" = 5' VER


RECORD DRAWING

\\ftms01\proj-jei\20033735\WaterMgmt\RECORD DRAWINGS\PP-WTP_to CorkscrewE1.dwg (PP 5A) jwm Oct 05, 2009 - 8:37am

| NO. | REVISIONS |
|-----|-----------|
| | |
| | |
| | |
| | |



Corkscrew 5 MGD
Wellfield Expansion

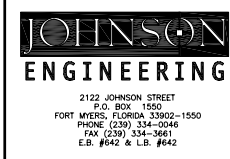

ERIK LEE HOWARD, PE
FL License No. 66574

Plan and Profile - WTP to Corkscrew East
Sta. 66+00 to Sta. 70+60

| DATE | PROJECT NO. | FILE NO. | SCALE | SHEET |
|-------------|-------------|----------|----------|-------|
| MARCH, 2006 | 20033735 | 16-46-26 | As Shown | PP 5A |