


NOTE:
USE EXTREME CAUTION.
OVERHEAD POWER IN AREA.

SEE SHEET 39 FOR
TYPICAL CROSS SECTIONS

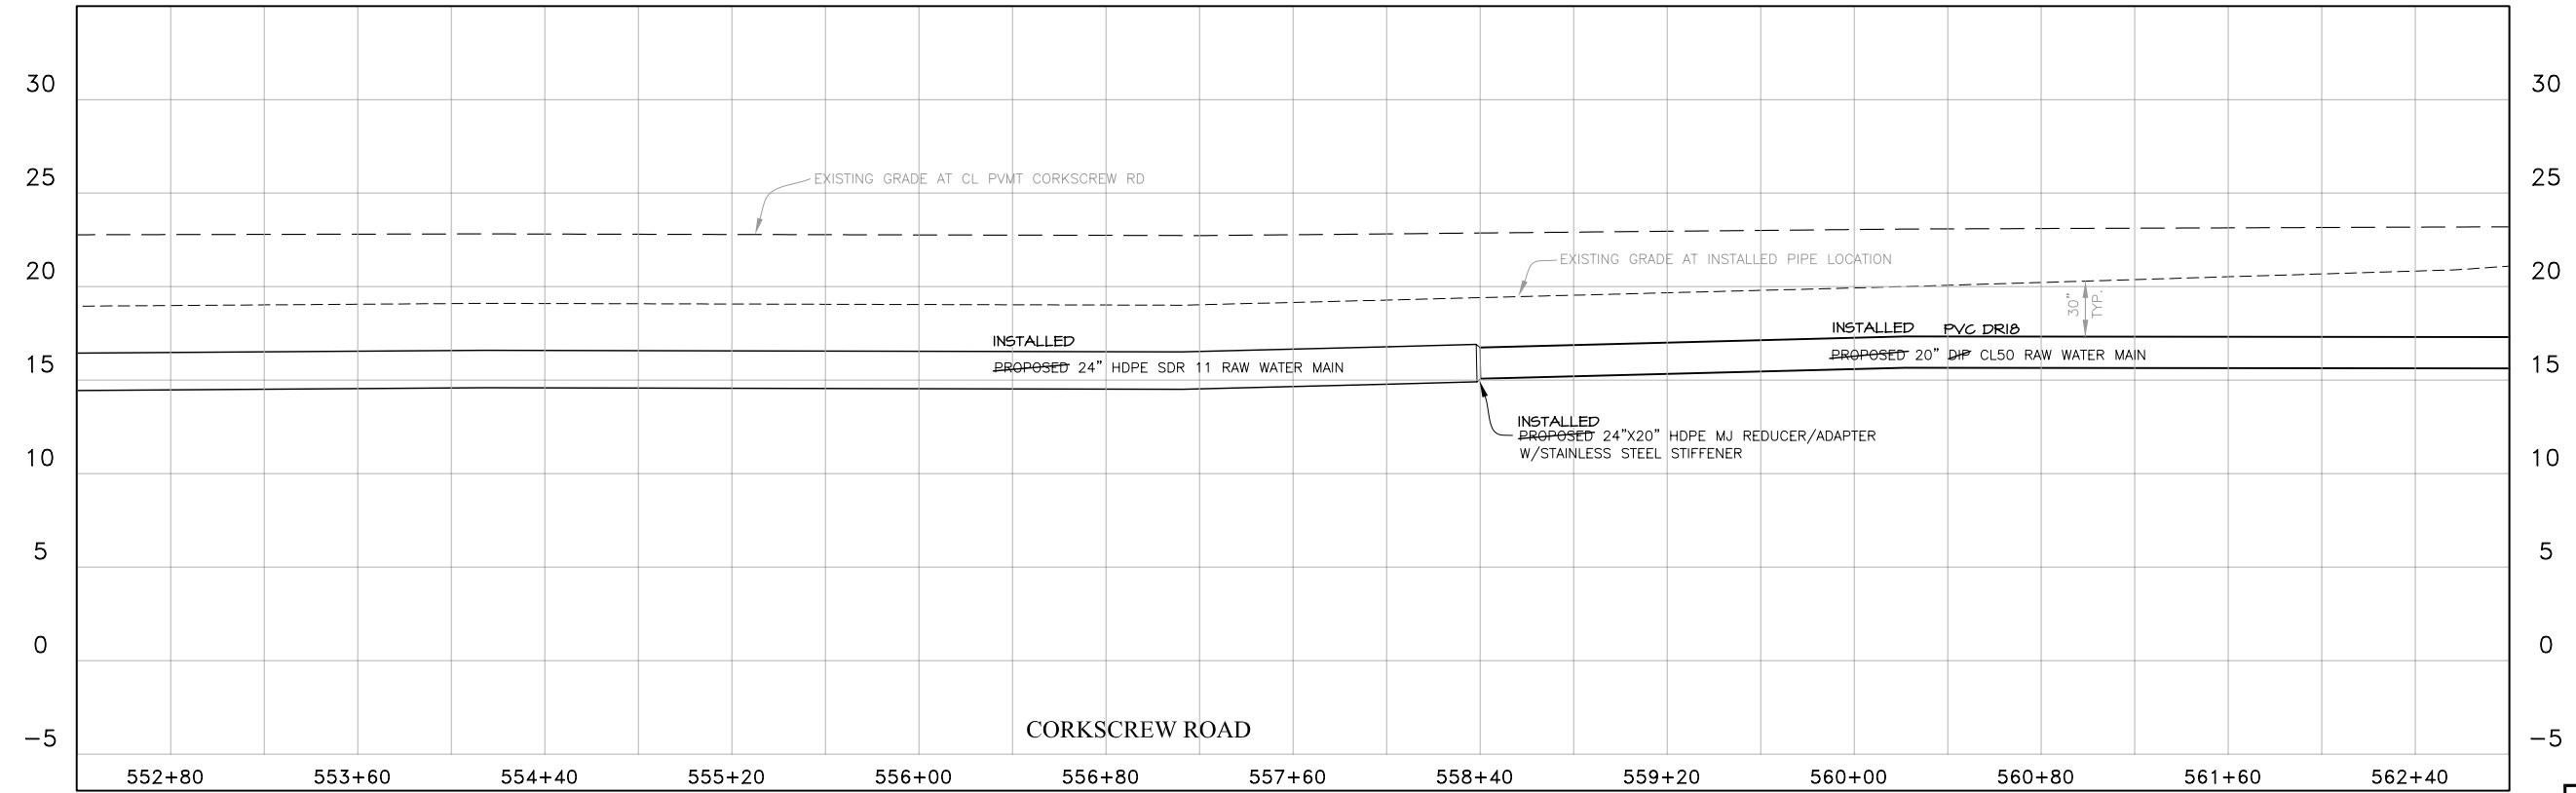

SCALE 1" = 40' HOR
1" = 5' VER


RECORD DRAWING

N:\20033735\WaterMgmt\RECORD DRAWINGS\PP-WTP_to CorkscrewE2.dwg (PP 15) jwm Oct 06, 2009 - 8:03am

REVISIONS	



Corkscrew 5 MGD
Wellfield Expansion

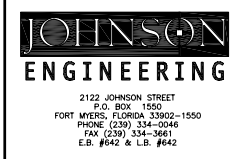

ERIK LEE HOWARD, PE
FL License No. 66574

Plan and Profile - WTP to Corkscrew East
Sta. 552+40 to Sta. 562+80

DATE	PROJECT NO.	FILE NO.	SCALE	SHEET
MARCH, 2006	20033735	16-46-26	As Shown	PP 15