

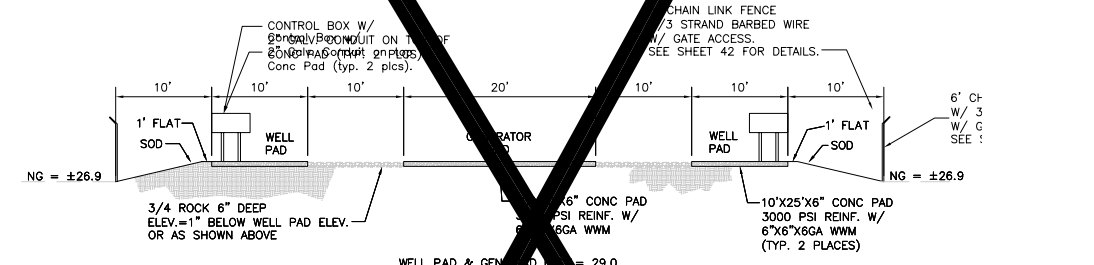


NOT CONSTRUCTED



WELL SITE 38

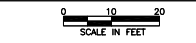



SECTION (X-X)

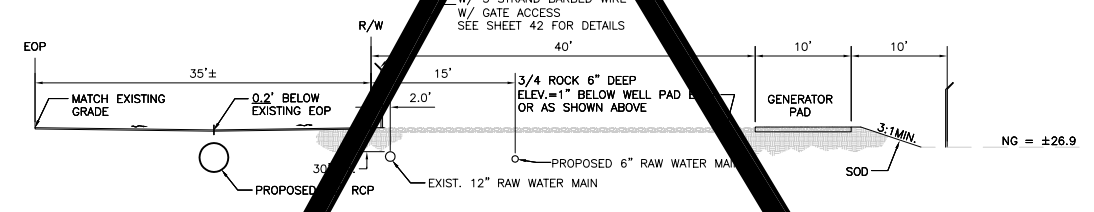



SECTION (Y-Y)

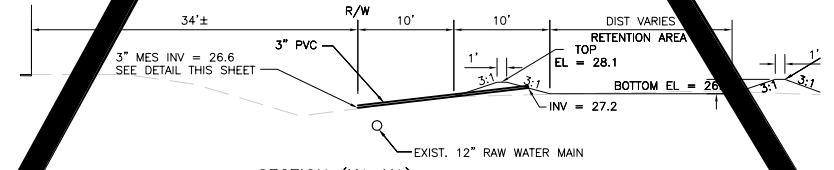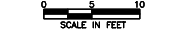



SECTION (Y1-Y1)

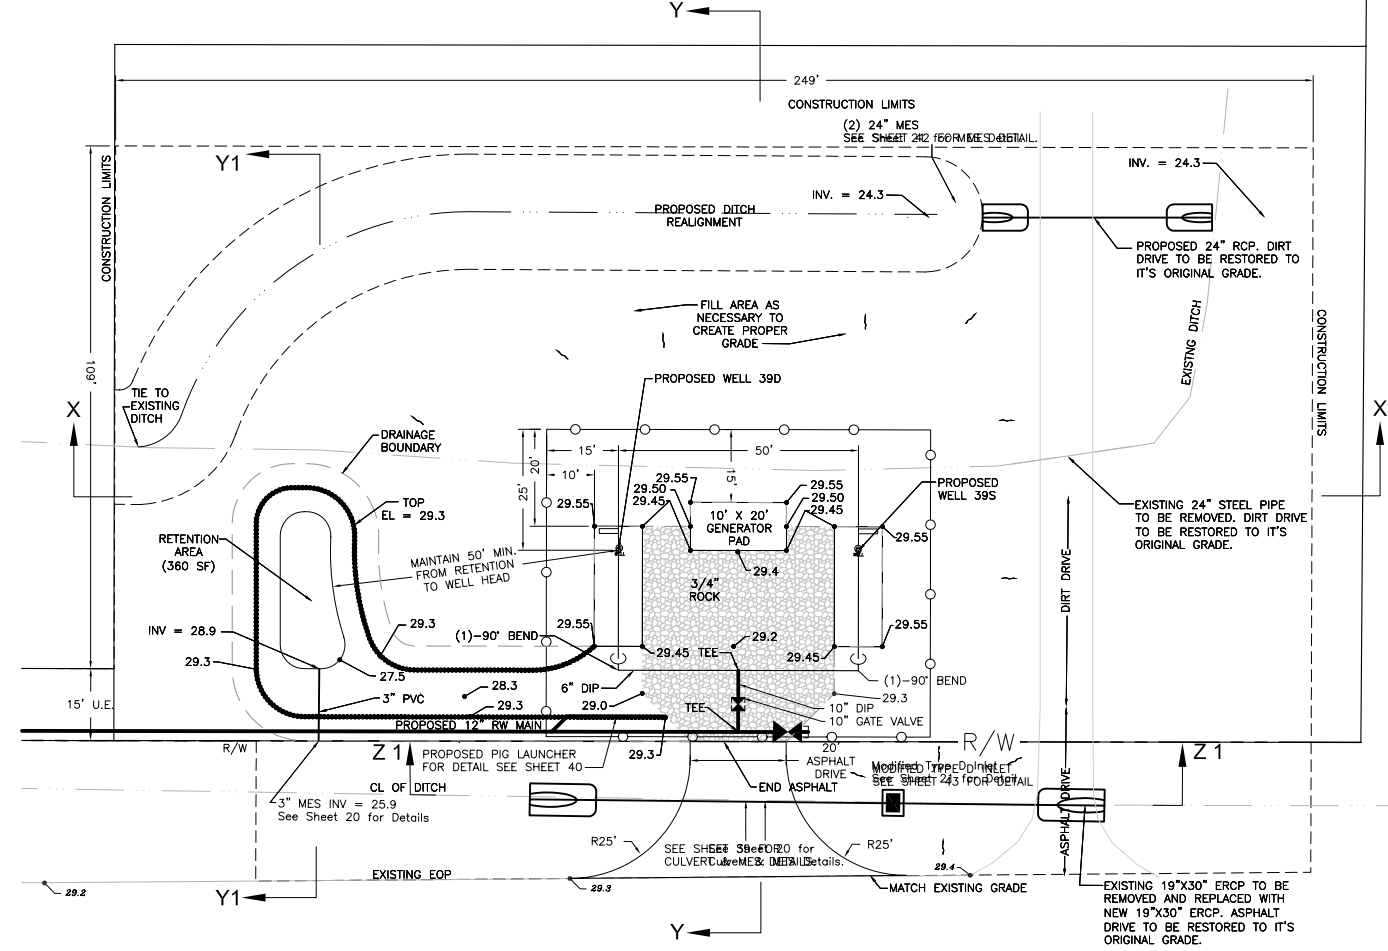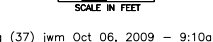



WELL SITE 39

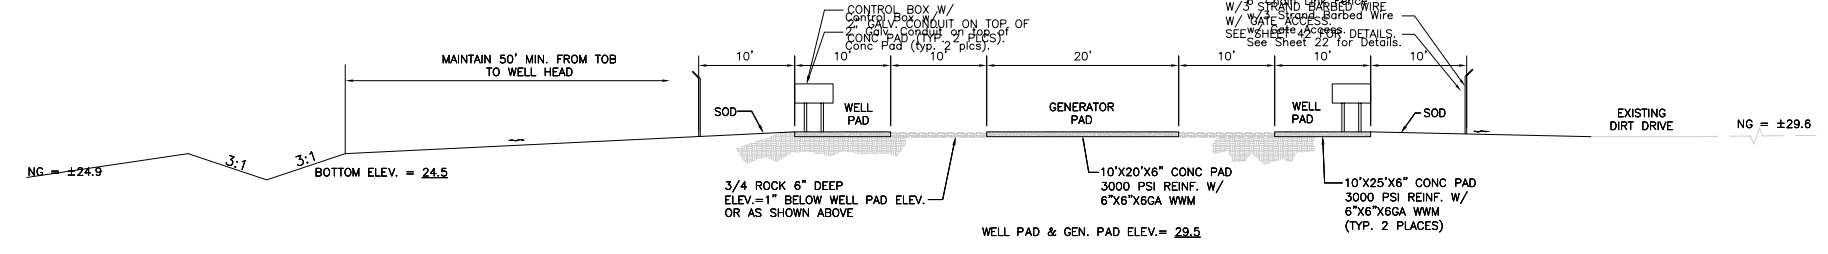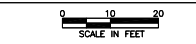


SECTION (X-X)

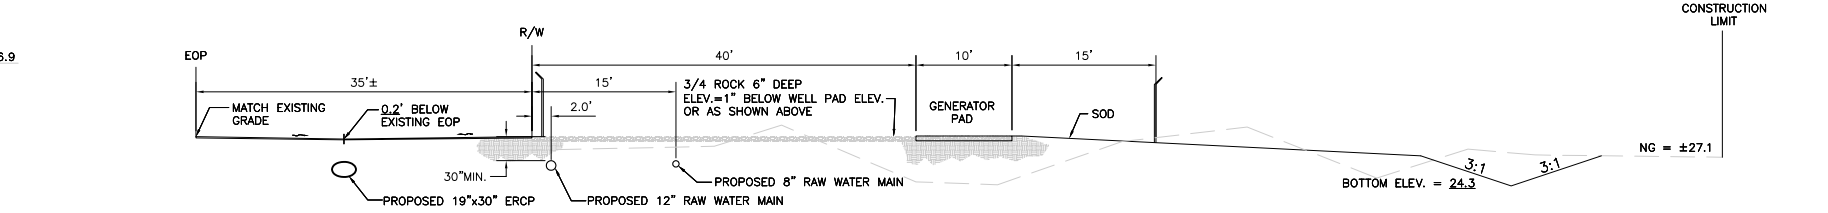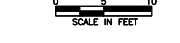

SECTION (Y-Y)

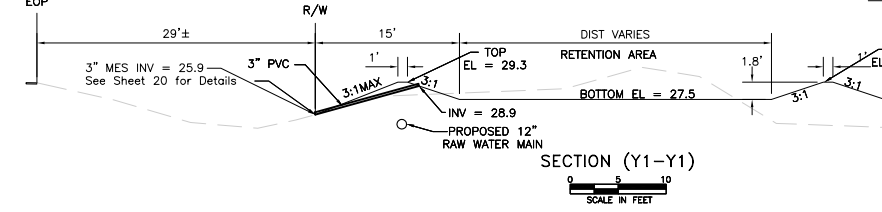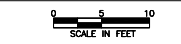

SECTION (Y1-Y1)

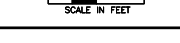


FOR AS-BUILT INFORMATION SEE SHEET 37A

\\ftms01\proj-jei\20033735\WaterMgmt\RECORD DRAWINGS\WELLSITELAYOUTNEW.dwg (37) jwm Oct 06, 2009 - 9:10am

NO.	REVISIONS



Corkscrew 5 MGD Wellfield Expansion

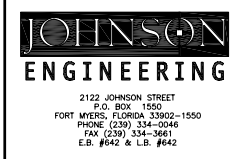

ERIK LEE HOWARD, PE
FL License No. 66574

Well Site Details & Sections				
DATE	PROJECT NO.	FILE NO.	SCALE	SHEET
JAN., 2009	20033735	16-46-26	As Shown	37