

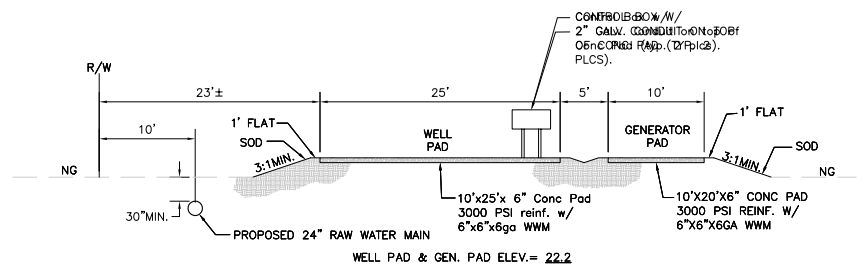




WELL SITE 40

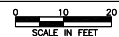



SECTION (Y-Y)

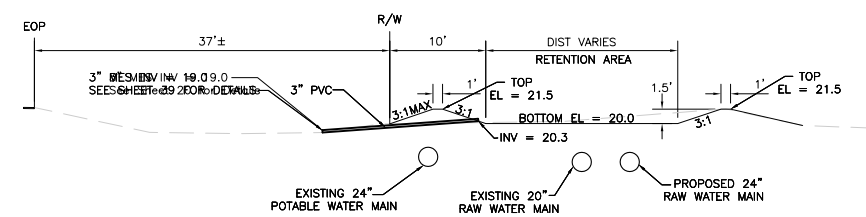


SECTION (Y1-Y1)

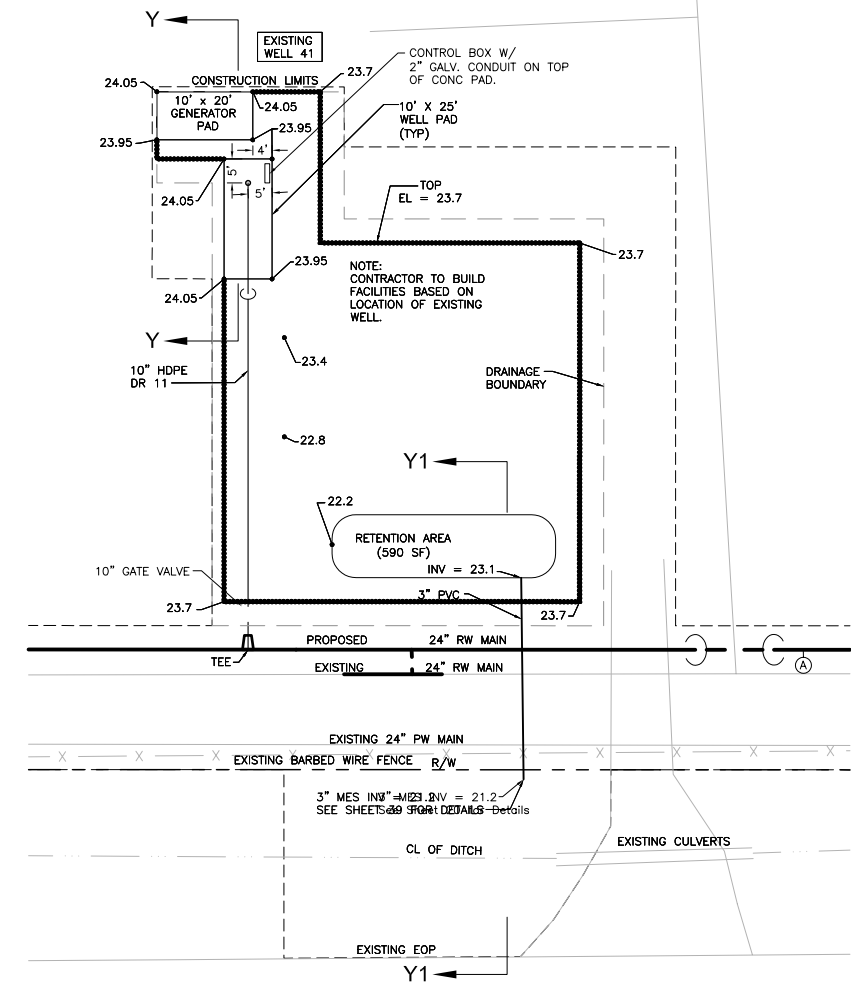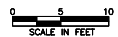


WELL SITE 41

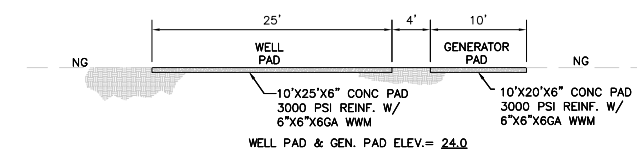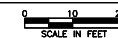

SECTION (Y-Y)

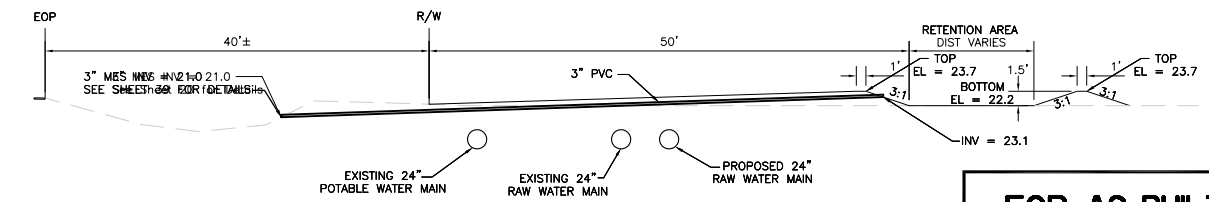

SECTION (Y1-Y1)

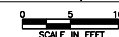


FOR AS-BUILT INFORMATION SEE SHEET 38A

\\fms01\proj-jel\20033735\WaterMgmt\RECORD DRAWINGS\WELL SITE LAYOUT NEW.dwg (38) jwm Oct 06, 2009 - 9:12am

NO.	REVISIONS



Corkscrew 5 MGD Wellfield Expansion

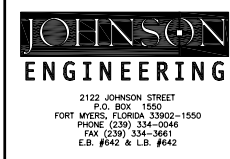

ERIK LEE HOWARD, PE
FL License No. 66574

Well Site Details & Sections				
DATE	PROJECT NO.	FILE NO.	SCALE	SHEET
JAN., 2009	20033735	16-46-26	As Shown	38